

These are the notes referred to on the following official copy ←

This means that the red statement at the foot of the following pages refers to the notes on this page

The electronic official copy of the title plan follows this message.

Please note that this is the only official copy we will issue. We will not issue a paper official copy.

This official copy was delivered electronically and when printed will not be to scale. You can obtain a paper official copy by ordering one from Land Registry.

This official copy is issued on 17 September 2016 shows the state of this title plan on 17 September 2016 at

10:28:30. It is admissible in evidence to the same extent as the original (s.67 Land Registration Act 2002).

This title plan shows the general position, not the exact line, of the boundaries. It may be subject to distortions in scale. Measurements scaled from this plan may not match measurements between the same points on the ground.

This title is dealt with by the Land Registry, Nottingham Office .

© Crown copyright. Produced by Land Registry. Reproduction in whole or in part is prohibited without the prior written permission of Ordnance Survey. Licence Number 100026316.

This is the date that this Title Plan was obtained.
This confirms that this is the latest version of the
Title Plan


H.M. Land Registry
~~Certificate Copy~~
~~of the~~
Filed Plan of Title No. K113810

Scale 1:2500



The scale at which the plan is drawn

The title number that this Title Plan relates to

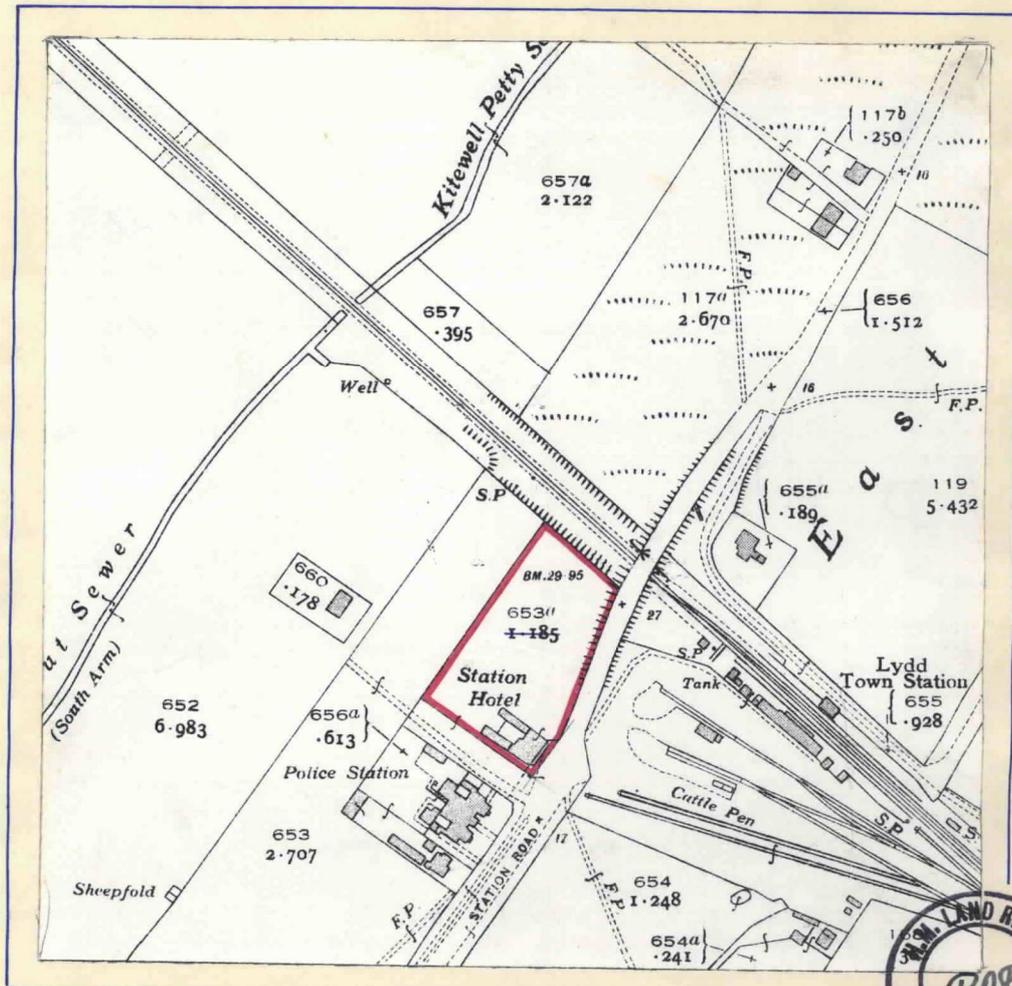

The date that this plan was drawn. The Land Registry do not create new plans unless the boundaries of the property change. Often, the latest version of a Title Plan was drawn in the 90's. This simply means that the boundaries have not changed since then, and the plan is still to be treated as 'current'

O.S. Sheet KENT. LXXXIV. 10.

This statement refers to the notes on the first page